




Front Elevation

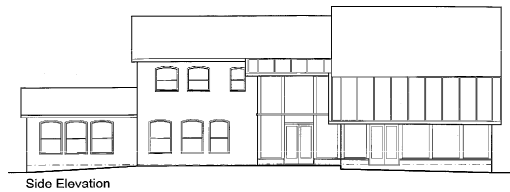


Side Elevation

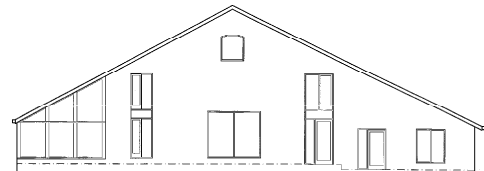


Rear Elevation

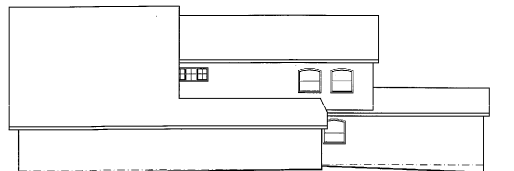

Side Elevation

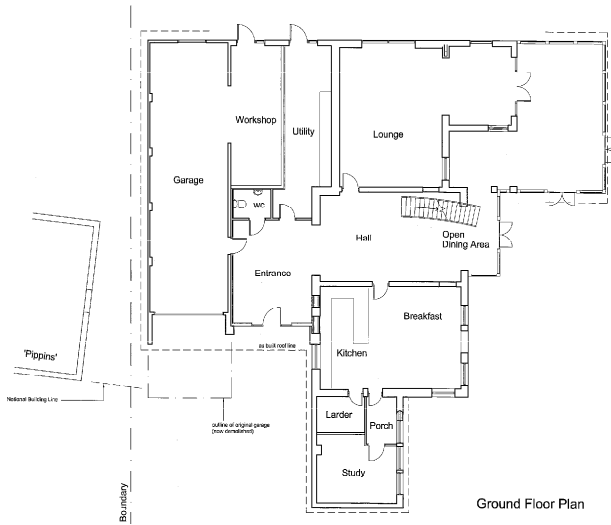

Ground Floor Plan

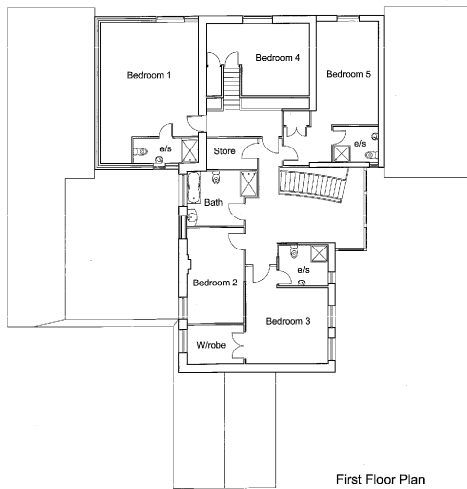

First Floor Plan



GENERAL NOTES
 1. THIS DRAWING IS SUBJECT TO CONDITIONS AND IS NOT TO BE REPRODUCED IN PART OR IN WHOLE WITHOUT APPROVAL.
 2. ALL WORK IS TO BE DONE IN ACCORDANCE WITH THE BUILDING REGULATIONS.

- approved
- proposed
- reserved
- other



Fletcher Smith
 ARCHITECTS

CLIENT	Mr & Mrs M Catterall	DATE	6/10/10 AM
PROJECT	Woodcock Barn, Runshaw Lane, Euxton, Preston	SCALE	1/40 30/11
DRAWN BY	BSH	DATE	28 June 2011
NO.	As Built Floor Plans & Elevations	PROJECT NO.	3137/150
11 Woodcock Business Village, Woodgate Way, Preston, PR2 2YB T: 0752 554646 F: 0752 554651			