


FRONT ELEVATION 1:100




SIDE ELEVATION

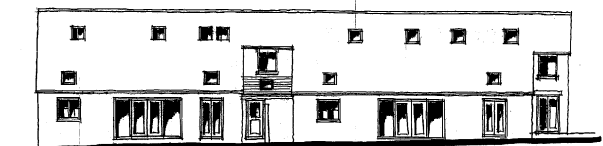


REAR ELEVATION


11/624

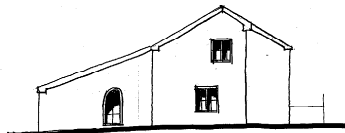


SIDE ELEVATION

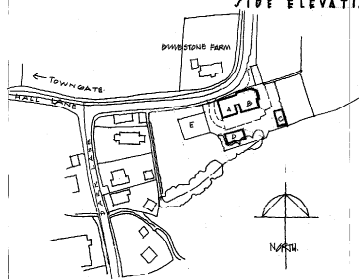


LOCATION PLAN 1:1000

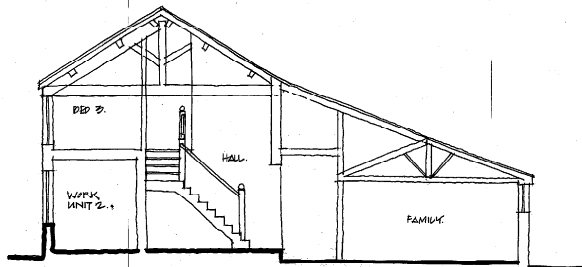

SECTION ON A-A 1:50

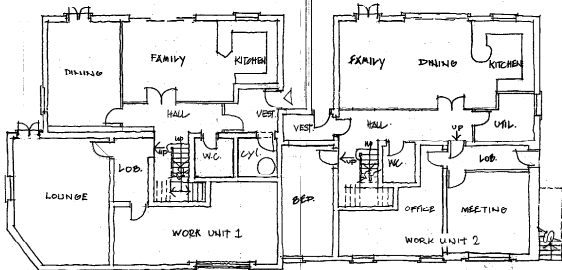

GROUND FLOOR LAYOUT 1:100

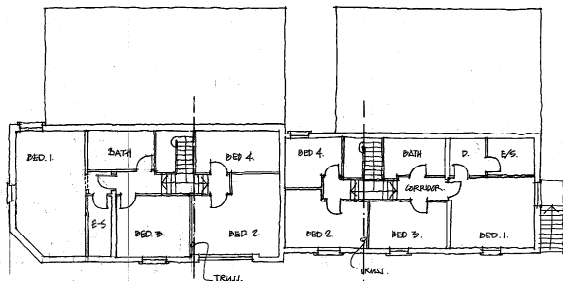

FIRST FLOOR LAYOUT

CHICHESTER COUNCIL
CORPORATE SUPPORT SERVICES
URBAN STREET POLICE
REF: 12 JUL 2011

REV D - AMENDED TO CORRESPOND WITH AS-BUILT SURVEY, 27/06/11 GJP
REV C - DIMS REVISION TO DRAW. ELEVATIONS OF ROOF ONLY & WINDOW DETAILS
ALTERED TO 3RD ELEV. APPROX. WINDOW PROTS. 6. 16/02/09 ASL
REV B - WALL TO UNIT 1. OUT BACK TO OPEN SANITARY ACCESS. 08/10/08 ASL
REV A - WALL TO SURROUND ROOF. (EXISTING) ADDED. BEST ELEVATION QUALITY
WINDOWS REDUCED TO WHITE. PITCH ONLY. OPENING AS SECTION. DIMENSIONS TO
WEST GABLE HALF ROOFED. 14/01/08 JPL

THOMAS MANDLEY (BUILDERS) LTD PROJECT: BULLINGTON BARN, BULLINGTON LANE, MANDLEY CONVERSION OF REDUNDANT BARN TO 2 NO LIVING/WORK UNITS. DRAWING TITLE: PROPOSED PLANS & ELEVATIONS. DATE: 03.05.07 SCALE: 1:100000 DRAWN BY: JPL CHECKED BY: 06/10/09 REV: D		 M.L.M.P. ARCHITECTURAL CONSULTANTS 225 PRINCE STREET CHESTER CHESHIRE CH1 1PL TEL: 01244 202222 FAX: 01244 202222 E-MAIL: info@mlmp.co.uk © Copyright Thomas Mandley (Builders) Limited 2007
11/624		