


# APPROVED PLANNING DETAILS

Extracted from Brock Carmichael Architects planning drawing  
08.141\_61\_P01


## PLAN

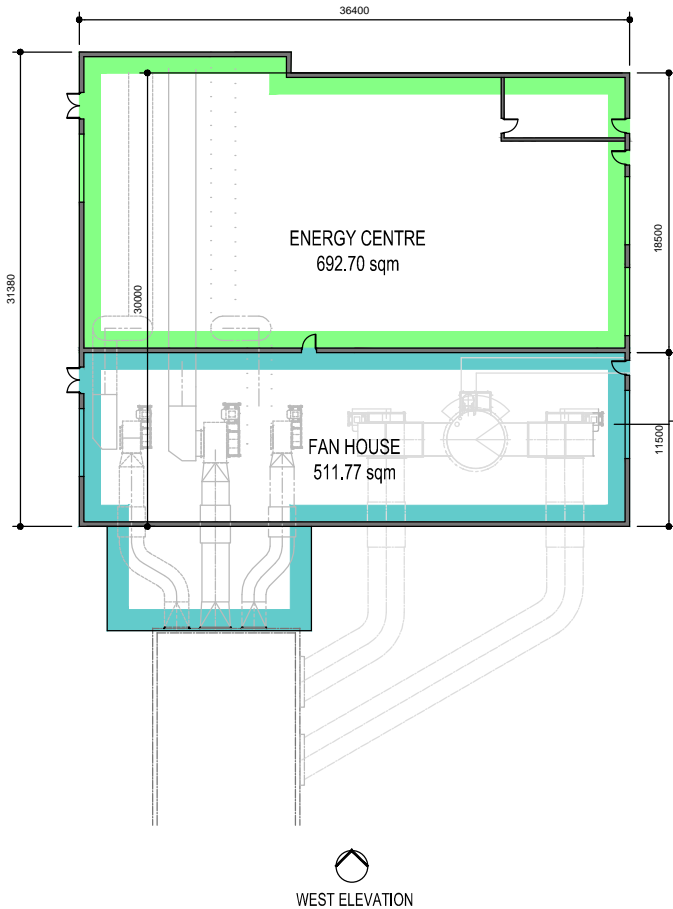

AREAS	
Fan House Area	511.77 sqm
Energy Centre Area	692.70 sqm
<b>Total</b>	<b>1,204.47 sqm</b>



# AS BUILT DETAILS (FAN HOUSE)

Extracted from Graham Schofield Associates drawing  
2010-070-003-C

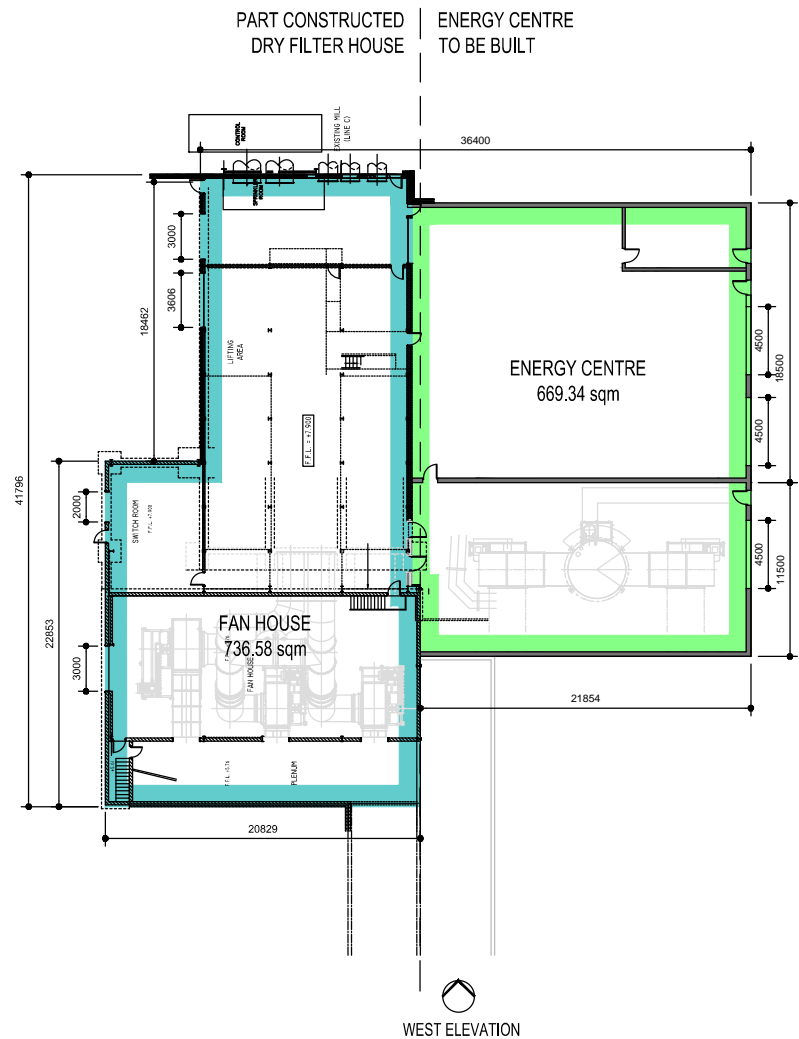

AREAS	
Fan House Area	736.58 sqm
Energy Centre Area	669.34 sqm
<b>Total</b>	<b>1,405.92 sqm</b>

## WEST ELEVATION

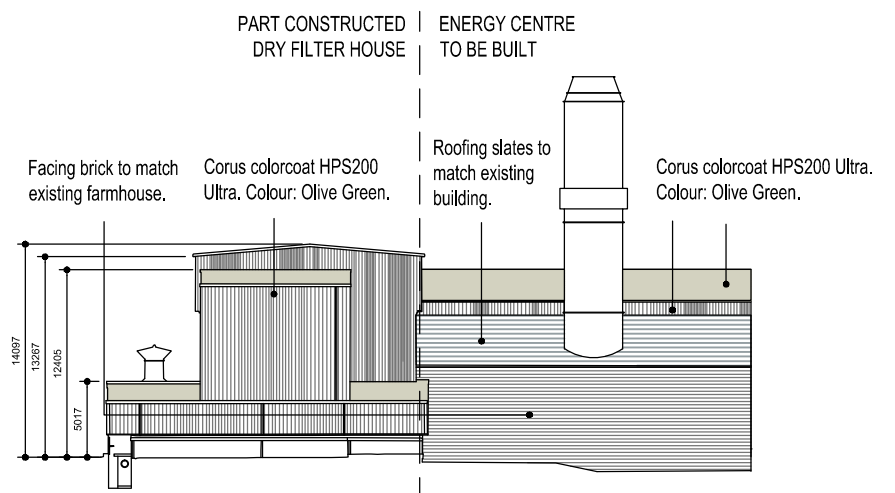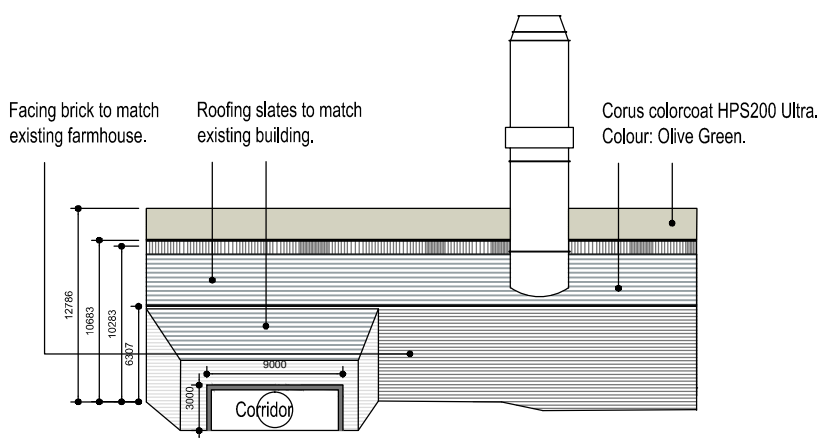

Client	GOLDEN ACRES GROUP LIMITED	Scale	1:500@A3	Drawn	MA	Checked	TH	Date	17/08/12
Job title	PLOCKS FARM, BRETHERTON	Job number	12.505	Drawing number	010	Rev	P01		
Drawing title	ENERGY CENTRE & FAN HOUSE COMPARISON								

19 OLD HALL STREET  
LIVERPOOL  
L3 9JQ  
TELEPHONE +44 (0)151 242 6161  
FACSIMILE +44 (0)151 236 4467  
EMAIL office@bcalandscape.co.uk  
WEB SITE www.bcalandscape.co.uk