



②9 LINE C INTAKE
West Elevation 1:250

APPROVED DRAWING

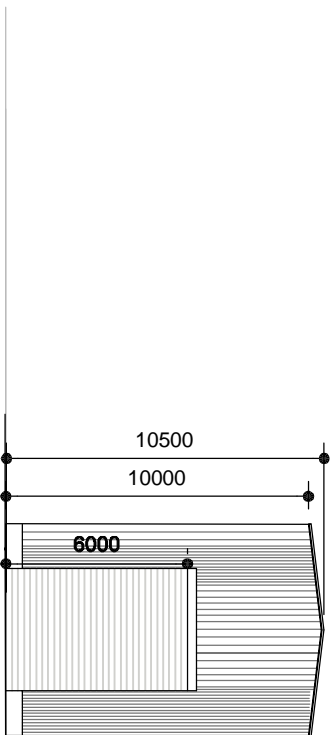

AS BUILT DRAWING

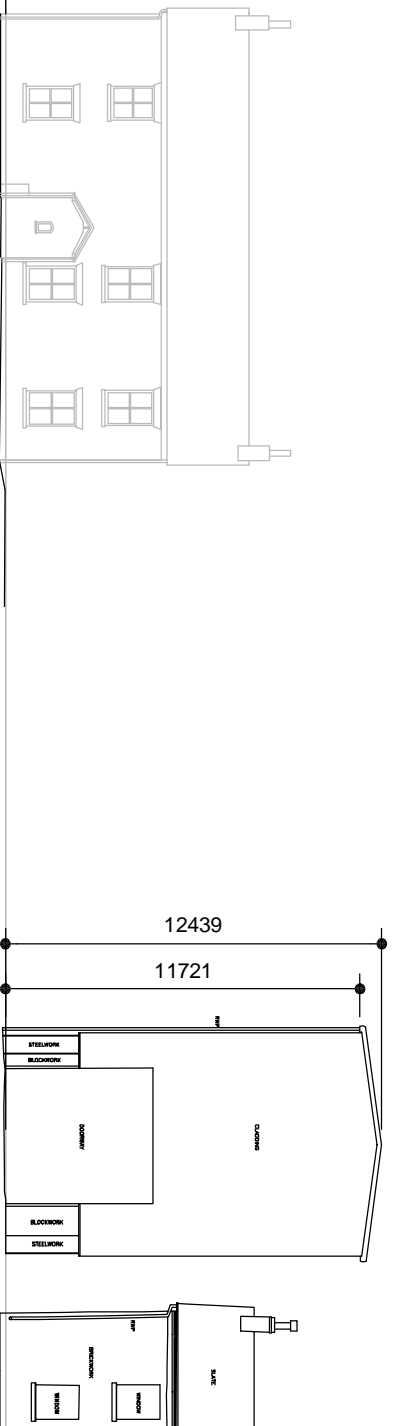

AS BUILT PHOTOGRAPH

PLOCKS FARM, BRETHERTON

GOLDEN ACRES GROUP LIMITED

PROPOSED DEVELOPMENT OF GOLDEN ACRES - MASTERPLAN

AMENDMENTS TO APPROVED PLANNING DRAWINGS (Ref: 09/00738/FULMAJ) - ELEVATION COMPARISON

19 OLD HALL STREET
LIVERPOOL
L3 9JQ
TELEPHONE +44 (0)151 242 6161
FACSIMILE +44 (0)151 236 4467
office@bcalandscape.co.uk
www.bcalandscape.co.uk

