



②9 LINE C INTAKE
North Elevation 1:250

APPROVED DRAWING

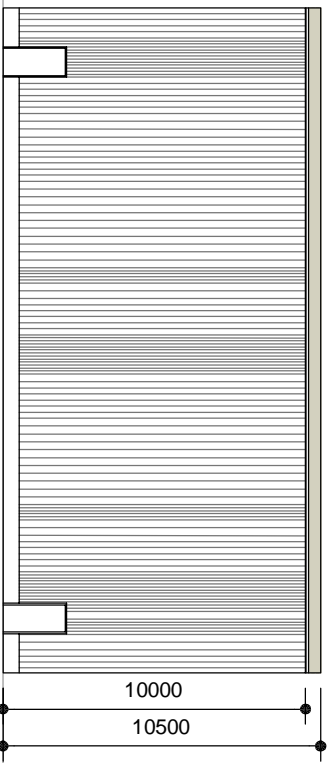

AS BUILT DRAWING

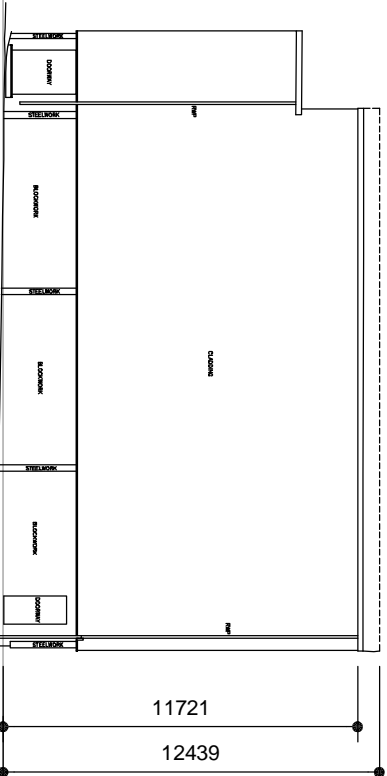

NOTE: Additional height required to accommodate HGV vehicles to tip their payload of raw ingredients within the building in order to contain the dust and odour.



PLOCKS FARM, BRETHERTON

GOLDEN ACRES GROUP LIMITED

PROPOSED DEVELOPMENT OF GOLDEN ACRES - MASTERPLAN

AMENDMENTS TO APPROVED PLANNING DRAWINGS (Ref: 09/00738/EI/MA 1) - ELEVATION COMPARISON

19 OLD HALL STREET
LIVERPOOL
L3 9JQ

TELEPHONE +44 (0)151 242 6161
FACSIMILE +44 (0)151 236 4467
office@bcalandscap.co.uk
www.bcalandscape.co.uk



BCA Landscape
005